
to

DECLARATION OF CONDOMINIUM

FOUR SEASONS OF ROMAR BEACH

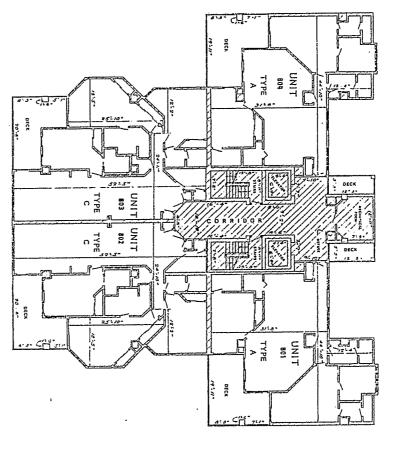

MISC. 59 40E 1425

THE UNDERSCHED, JAMES T. COMMAN, A RECISTERED DEPCHER IN THE STATE OF ALABAMA, NUMBER 2351, PARSIMANT TO SECTION 19-14. CODE OF ALABAMA, 1873, INTERIN CENTRY THAT THE DRAWINGS CONSISTING OF PACES ? THEOCHAR F. INCLUSIVE ATTACHED TO AND MADE. A PART OF THE DECLARATION OF COMMONIME OF DRESS ESSAYS OF NOWAR REACH, A CONDUMINUM. FULLY AND ACCURATELY DETICT THE LAYOUT, LOCATIONS, UNIT NUMBERS AND DIVENSIONS HE SUFFICIET THAT LAYOUT, LOCATIONS, UNIT NUMBERS AND DIVENSIONS HE SUFFICIETY DETAILS COMMENTED AND ACCURATELY DETAILS COMMENTED AND ACCURATE COMMENTS OF THE SEASONS OF ROMAN REACH.

ANES - CHAPTAGE SAME ALCADINI 9-17-87

A CONDOMINIUM, AS BUILT.

COUNTY OF BALDWIN

3 0 8 .16 20 Graphic Scole

CEILING ELEV. 91.5' M.S.L. EIGHTH FLOOR

SCALE: 1/8" = 1'0"

FLOOR ELEV.

85.7' M.S.L.

NUILDARIE AREA OF THE ABOVE PROPERTY LIES IN TOPE C 5500 YEAR FLOOD) ACCORDING TO THE FLOOD DEVIRANCE DATE WAS (1984) COMMINITY NO. DISPO. PAGE NO. DISPO. STORY ) THE FLOOR OF THE FLOOR OF THE PROPERTY AND THE II IS SAY OPHINON THAT THE

PHASE T EIGHTH FLOOR

ORANGE PEACH, ALABASA FOUR SEASONS OF ROMAR BEACH

or, 9,7 a S. P. S.E. Baldula County, AL

P.D to 113 Colf Shores, AL 2531

NON-CROSS HATCHED AREA
REPRESENTS PRIVATE EL'UENTS.

ALL BEING 1.4 ACRES, NURE OR LESS, AND LYING IN SECTION 1, TOWNSHIP 4 SOUTH, RANGE 1 FAST, INJINNIN COUNTY, ALABAMA,

LECAL DESCRIPTION: THE ABOVE UNITS ARE LOCATED ON THE FOLLOWING DESCRIBED PROPERTY.

OF NAY OF ALABAMA HIGHMAY 115. 164 FEETS HIM THEMEE S YANSHAF E,

IN FEETS HIM THEMEE S RAYSHAF N. 30 FEETS HIM THEMEE N WATER

IN FEETS AND THEMEE S RAYSHAF N. 10 FEETS HIM THEMEE S WATER F,

IN FEETS HIM THEMEE S RAYSHAF N. 10 FEETS HIM THEMEE S RAYSHAF N.

10 FEETS HIM THEMEE S RAYSHAF N. 10 FEETS HIM THEMEE S RAYSHAF N.

10 FEETS HOW THEMEES SAYSHAF N. 10 FEETS HAW THEMEES S WATER M.

11 FEETS HOW THEMEES SAYSHAF N. 10 FEETS HAW THEMEES S WATER M.

10 FEETS HOW THEMEES SAYSHAF N. 10 FEETS HAW THEMEES SAYSHAF N.

10 FEETS HOW THEMEES SAYSHAF N. 10 FEETS HAW THE MARCH M.

11 HE COLL OF LESSED, 11 FEETS, WANG ON LESS, TO THE MEST LINE

11 FEETS HAW THEMEES HAW THE MARCH M. 11 FEETS HAW THE MEST LINE

12 FEETS HAW THEMEES SAYSHAF N.

13 FEETS HAW THEMEES SAYSHAF N.

14 FEETS HAW THEMEES SAYSHAF N.

15 FEETS HAW THEMEES SAYSHAF N.

16 FEETS HAW THEMEES SAYSHAF N.

16 FEETS HAW THEMEES SAYSHAF N.

16 FEETS HAW THEMEES SAYSHAF N.

17 FEETS HAW THEMEES SAYSHAF N.

17 FEETS HAW THEMEES SAYSHAF N.

18 FEETS HAW TH BECIMMING AT THE MORTHWEST CORNER OF LOT 7 RUSSELL'S SUBDIVISION AS RECORDED IN MAY BOOK J. PAGE 111, PROBATE RECORDS, BALDWIN COUNTY, ALABAMA RUN THENCE N 15796'H" E ALDNG THE FOUTH RICHT OF SAID LOT 2; RUN THENCE N 00-21/30" E. 341 FEET, WORE-OR LESS, TO THE NORTHWEST CORNER OF SAID LOT 1. AND THE POINT OF BEGINNING.

CHOSS HATCHED AREA
REPRESENTS COMMON ELEMENTS NO CHRISTS COMMON ELENERS