



ROADSIDE

**THIRD FLOOR PLAN**  
SCALE 1/8" = 1'-0"

- GROSS HATCHED AREAS AND ALL WALLS REPRESENT COMMON ELEMENTS
- REVERSED GROSS HATCHED AREAS REPRESENT COMMON ELEMENTS (BALCONIES)
- NON-GROSS HATCHED AREAS WITH THE POSITION OF WALLS REPRESENT PRIVATE ELEMENTS

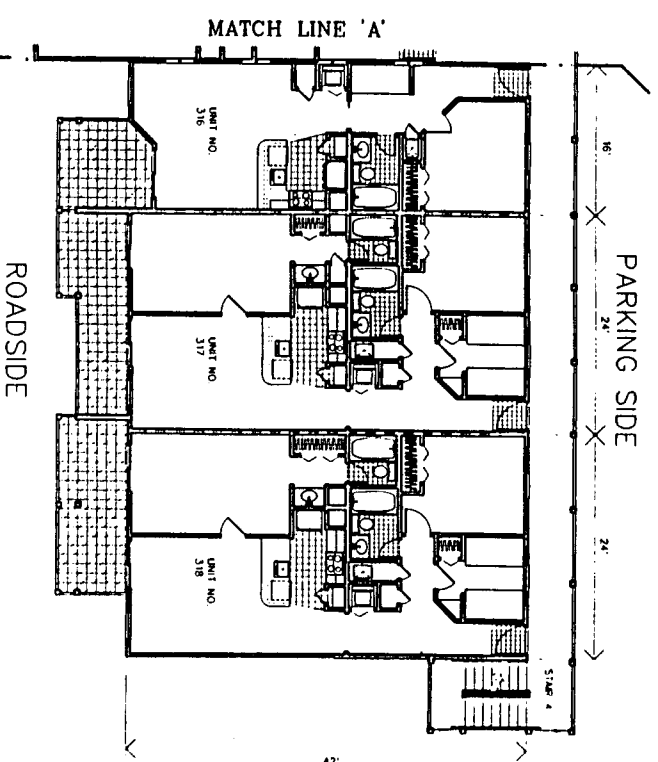

ROADSIDE

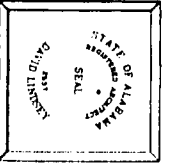

**DAVID LINDSEY, ARCHITECT**  
DESIGN, PLANNING, INTERIORS  
111 N. SUKUMPT STREET FAIRHOPE ALABAMA 36532  
(334) 990-7447 FAX (334) 990-7443

**COMPOSITE THIRD FLOOR PLAN**

DATE: 6 JUNE 1999

As-Built Drawings for  
**The GRAND BEACH RESORT**  
Gulf Shores, Alabama

PROJ# 96-106

SHEET NO. **4** OF