


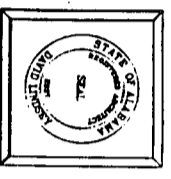
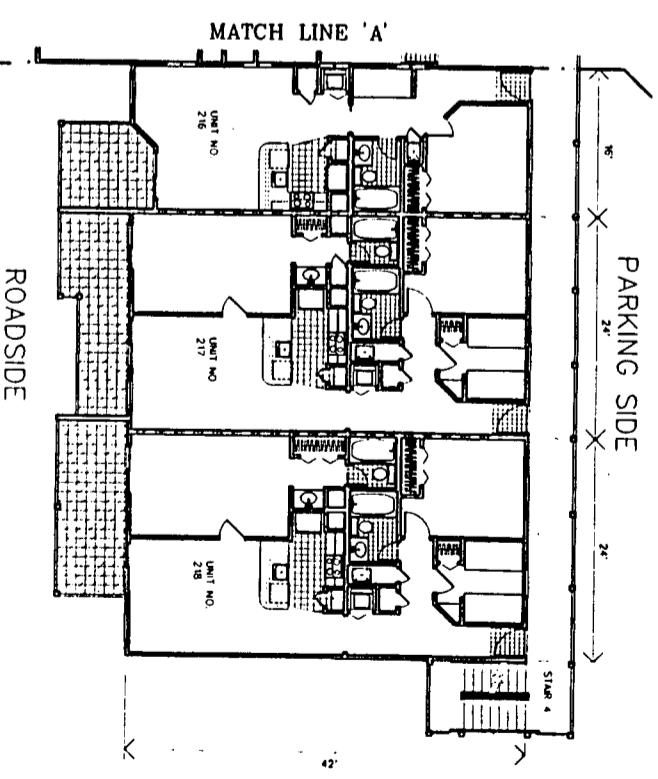


SECOND FLOOR PLAN

SCALE 1/8" = 1'-0"

-  GROSS HATCHED AREAS AND ELEMENTS REPRESENT COMMON ELEMENTS
-  REVERSED GROSS HATCHED AREAS ELEMENTS (BALCONIES)
-  NON-GROSS HATCHED AREAS WITH THE EXCEPTION OF WALLS REPRESENT PRIVATE ELEMENTS



DAVID LINDSEY, ARCHITECT
 DESIGN, PLANNING, INTERIORS
 (334) 990-7447
 111 N. SUMMIT STREET FAIRHOPE ALABAMA 36532
 FAX (334) 990-7443

COMPOSITE SECOND FLOOR PLAN

DATE: 6 JUNE 1999

As-Built Drawings for
The GRAND BEACH RESORT
 Gulf Shores, Alabama

PROJECT # 96-06

SHEET NO. **3** OF