
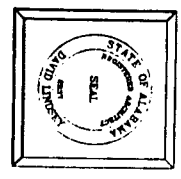


PENTHOUSE FLOOR PLAN
 SCALE 1/8" = 1'-0"

- CROSS HATCHED AREAS AND ALL WALLS REPRESENT COMMON ELEMENTS
- REVERSED CROSS HATCHED AREAS REPRESENT LIMITED COMMON ELEMENTS (BALCONIES)
- NON-CROSS HATCHED AREAS WITH THE EXCEPTION OF WALLS REPRESENT PRIVATE ELEMENTS

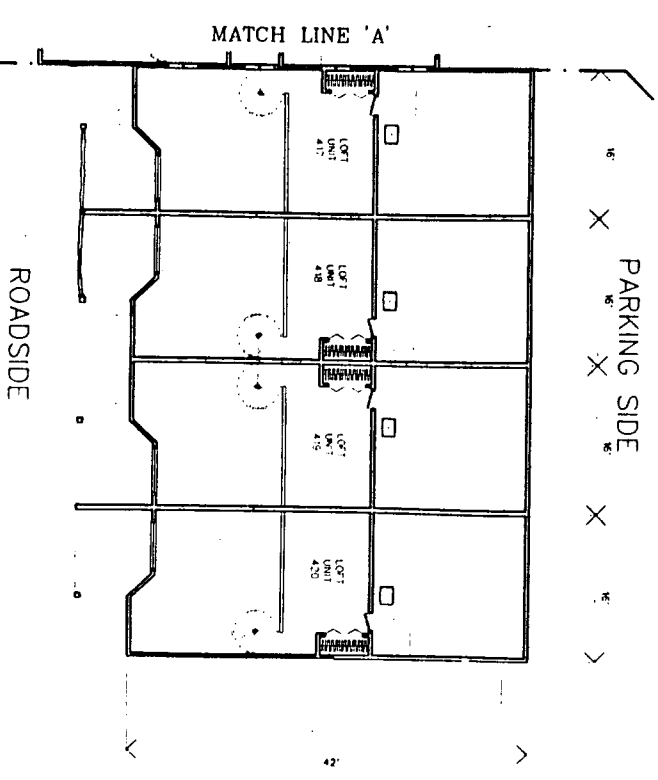

DAVID LINDSEY, ARCHITECT
 DESIGN, PLANNING, INTERIORS
 (334) 990-7447
 111 N. SUNDY STREET FAIRHOPE ALABAMA 36532
 FAX (334) 990-7443

COMPOSITE PENTH./LOW. LOFT FLOOR PLAN

DATE: 6 JUNE 1998

As-Built Drawings for
The GRAND BEACH RESORT
 Gulf Shores, Alabama

PROJ # 98-09

SHEET NO. **6** OF