



ROADSIDE

FOURTH FLOOR PLAN
SCALE 1/8" = 1'-0"

- GROSS HATCHED AREAS AND ALL WALLS REPRESENT COMMON ELEMENTS
- REVERSED GROSS HATCHED AREAS REPRESENT LIMITED COMMON ELEMENTS (BALCONIES)
- NON-GROSS HATCHED AREAS WITH THE EXCEPTED ELEMENTS REPRESENT PRIVATE ELEMENTS

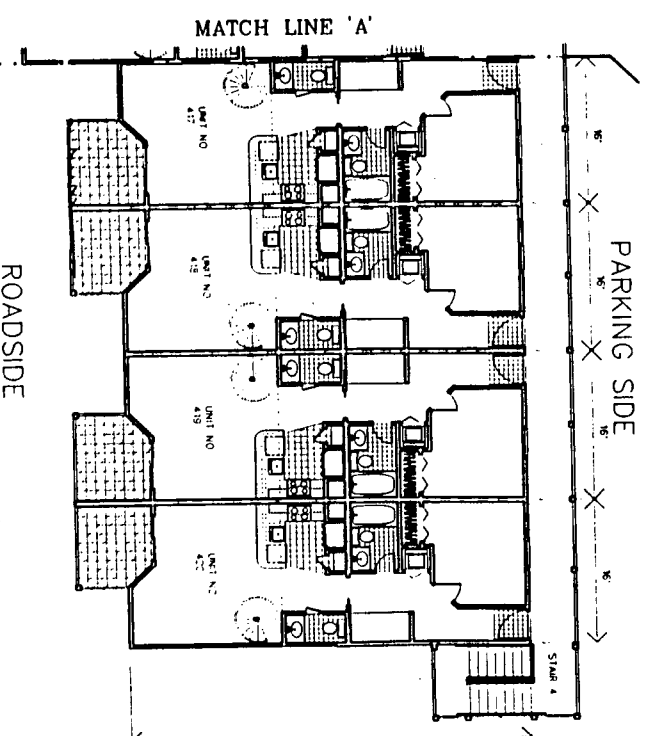

ROADSIDE

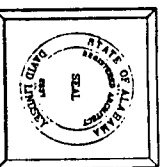

DAVID LINDSEY, ARCHITECT
DESIGN, PLANNING, INTERIORS
111 N. SUMMIT STREET FAIRHOPE ALABAMA 36532
(334) 890-7447 FAX (334) 890-7443

COMPOSITE FOURTH FLOOR PLAN

DATE: 6 JUNE 1999

As-Built Drawings for
The GRAND BEACH RESORT
Gulf Shores, Alabama

PROJ 96-106

SHEET NO. **5** OF