


MS

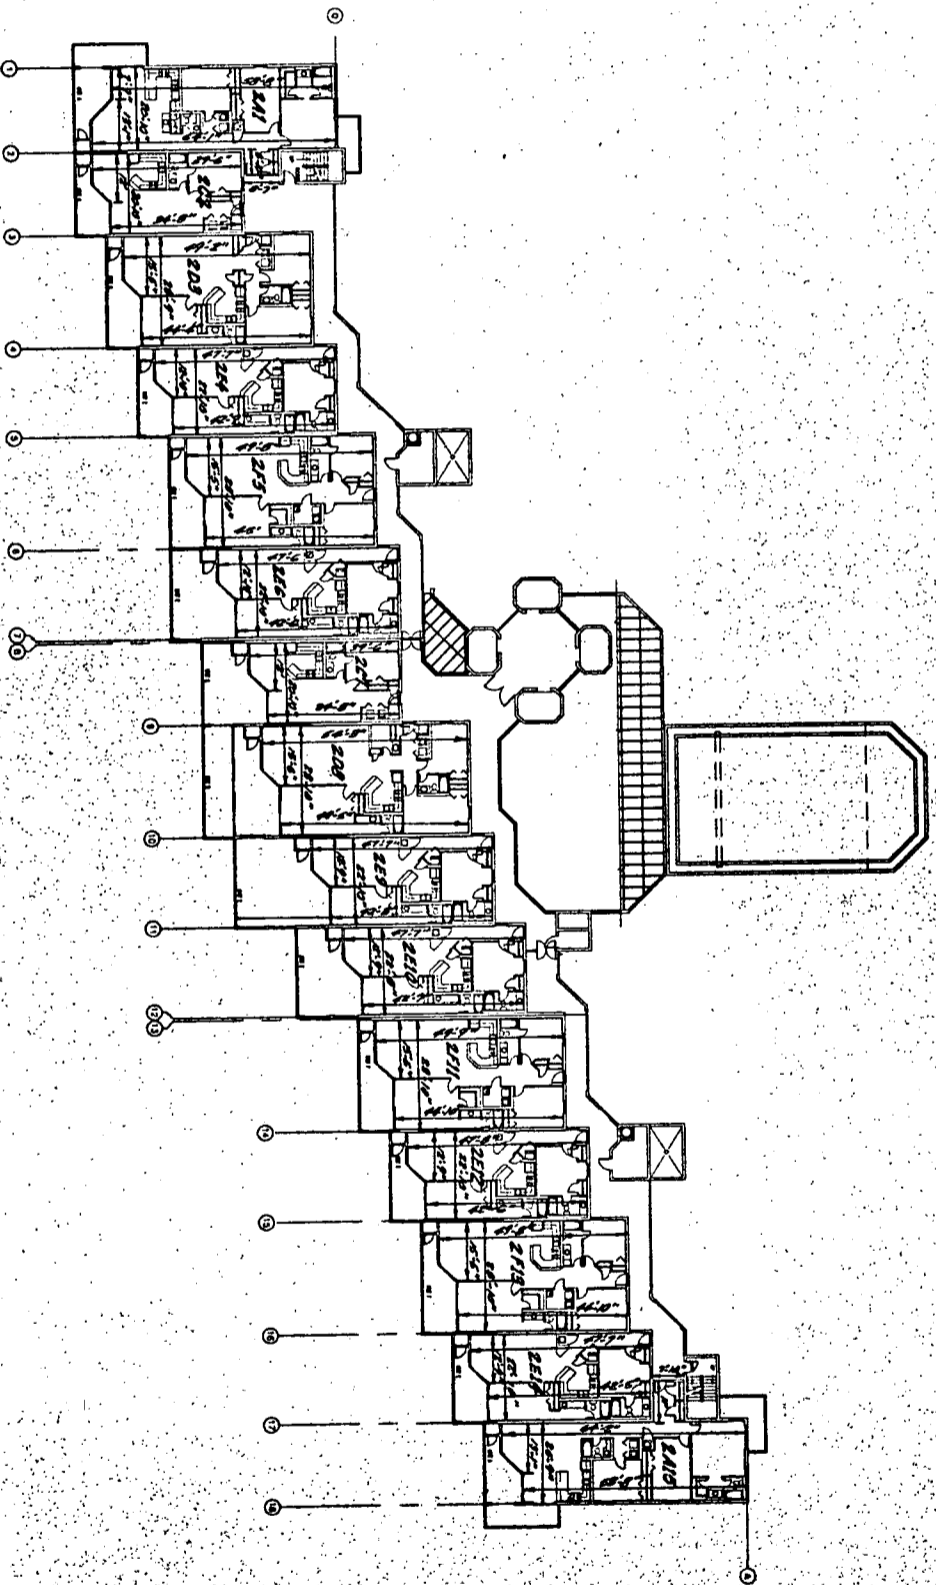

SECOND FLOOR PLAN

I, MIKELL D. SPEAKS, A REGISTERED LAND SURVEYOR IN THE STATE OF ALABAMA, HEREBY CERTIFY THAT THE FOLLOWING DIMENSIONS AND HEIGHTS IN PHOENIX VII CONDOMINIUMS ARE TRUE AND CORRECT.

Mikell D. Speaks
 ALABAMA REGISTRATION NO. 9127
 SEPTEMBER 20, 1999

MIKELL D. SPEAKS & ASSOCIATES • CONSULTING ENGINEERS, INCORPORATED
 732 OAK CIRCLE DRIVE WEST • MOBILE, ALABAMA

PHOENIX VII
 "AS BUILT"

BUSINESS RECORDS CORPORATION

019 002 123