
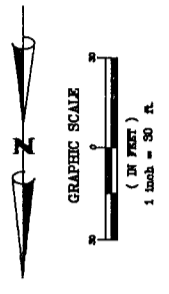


APT 25  
Page 61-84

Apt Bk 25 Pg 61

State of Alabama, Baldwin County  
I certify this instrument was filed  
and taxes collected on:  
2006 December -28 10:40AM  
Instrument Number 1022306 Pages 24  
Recording 240.00 Mortgage  
Deed  
Index  
Archive 5.00  
Adrian T. Johns, Judge of Probate

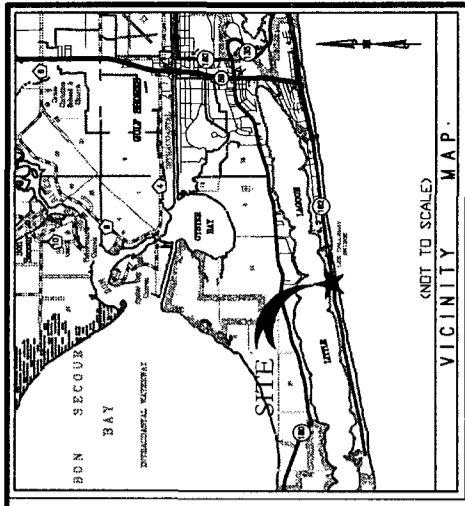

- GENERAL SURVEYOR'S NOTES:**
- SOURCES OF INFORMATION USED TO FACILITATE THIS SURVEY WERE PREVIOUS SURVEYS BY THIS OFFICE AND OTHERS. ALL INFORMATION WAS OBTAINED FROM THE PUBLIC RECORDS OF BALDWIN COUNTY, ALABAMA. NO FIELD RESEARCH OR RECONSTRUCTION WAS PERFORMED BY THIS FIRM. THERE MAY BE DEEDS OF RECORD, UNRECORDED DEEDS, EASEMENTS, RIGHT-OF-WAYS, OR OTHER INSTRUMENTS OF RECORD WHICH COULD AFFECT THE BOUNDARIES OF THIS PROPERTY THAT WERE NOT FURNISHED AT TIME OF SURVEY.
  - ALL BEARINGS ARE BASED ON THE NORTH RIGHT-OF-WAY LINE OF WEST GULF SHORES BOULEVARD, AS BEING S-79°33'00"-W, AS PER RECORDED PLAT.
  - I HAVE CONSULTED THE FEDERAL INSURANCE ADMINISTRATION MAP, COMMUNITY PANEL NO. 010030951 K, EFFECTIVE DATE JUNE 17, 2002, AND FOUND THAT THE DESCRIBED PROPERTY IS LOCATED IN FLOOD ZONE "AE", BASE FLOOD ELEVATION DETERMINED TO BE "1'0" AND ZONE "VE", COASTAL FLOOD WITH VELOCITY HAZARD (WAVE ACTION); BASE FLOOD ELEVATION DETERMINED TO BE "1'2".
  - FIELD WORK FOR THIS SURVEY WAS PERFORMED FROM DECEMBER 18-21, 2006.
  - ANY FLOOD ZONES GIVEN OR SHOWN ON THE FACE OF THIS PLAT ARE SCALED FROM THE FEDERAL EMERGENCY MANAGEMENT AGENCY FLOOD INSURANCE MAPS. (SCALED ONLY).
  - THIS SURVEY IS AN AS-BUILT OF BEL SOLE CONDOMINIUM SHOWING ONLY THOSE IMPROVEMENTS CONSTRUCTED AS OF DECEMBER 21, 2006. CONSTRUCTION OF THIS PROJECT IS STILL UNDERWAY AND IN NO WAY IS IT THE INTENT OF THIS FIRM TO REPRESENT THE CONSTRUCTION OF THIS PROJECT AS BEING COMPLETE OR TO MEET THE REQUIREMENTS OF AN AS-BUILT SURVEY AS SET FORTH BY THE CITY OF GULF SHORES. SAID SURVEY WAS PREPARED TO SATISFY THOSE REQUIREMENTS SET FORTH UNDER THE ALABAMA UNIFORM CONDOMINIUM ACT (§ 35-8A-209) ONLY.



**DESCRIPTION:**

LOT 18, BLOCK 1, LAGOON ESTATES No. 2 OF GULF SHORES, ALABAMA AS RECORDED IN MAP BOOK 4, PAGE 149 AND LOT "19-A" OF THE REPARTITION OF LOT 19, LAGOON ESTATES No. 2 OF GULF SHORES, ALABAMA, MAP BOOK 11, PAGE 66, OFFICE OF THE JUDGE OF PROBATE, BALDWIN COUNTY, ALABAMA.

HEREBY STATE THAT ALL PARTS OF THIS SURVEY AND DRAWING HAVE BEEN COMPLETED IN ACCORDANCE WITH THE CURRENT REQUIREMENTS OF THE STANDARDS OF PRACTICE FOR LAND SURVEYING IN THE STATE OF ALABAMA TO THE BEST OF MY KNOWLEDGE, INFORMATION, AND BELIEF.

ERIC L. GODWIN, P.L.S.  
ALABAMA LICENSE NUMBER 26621

12/27/06  
DATE

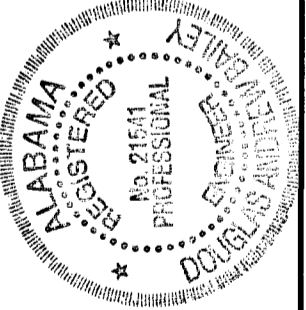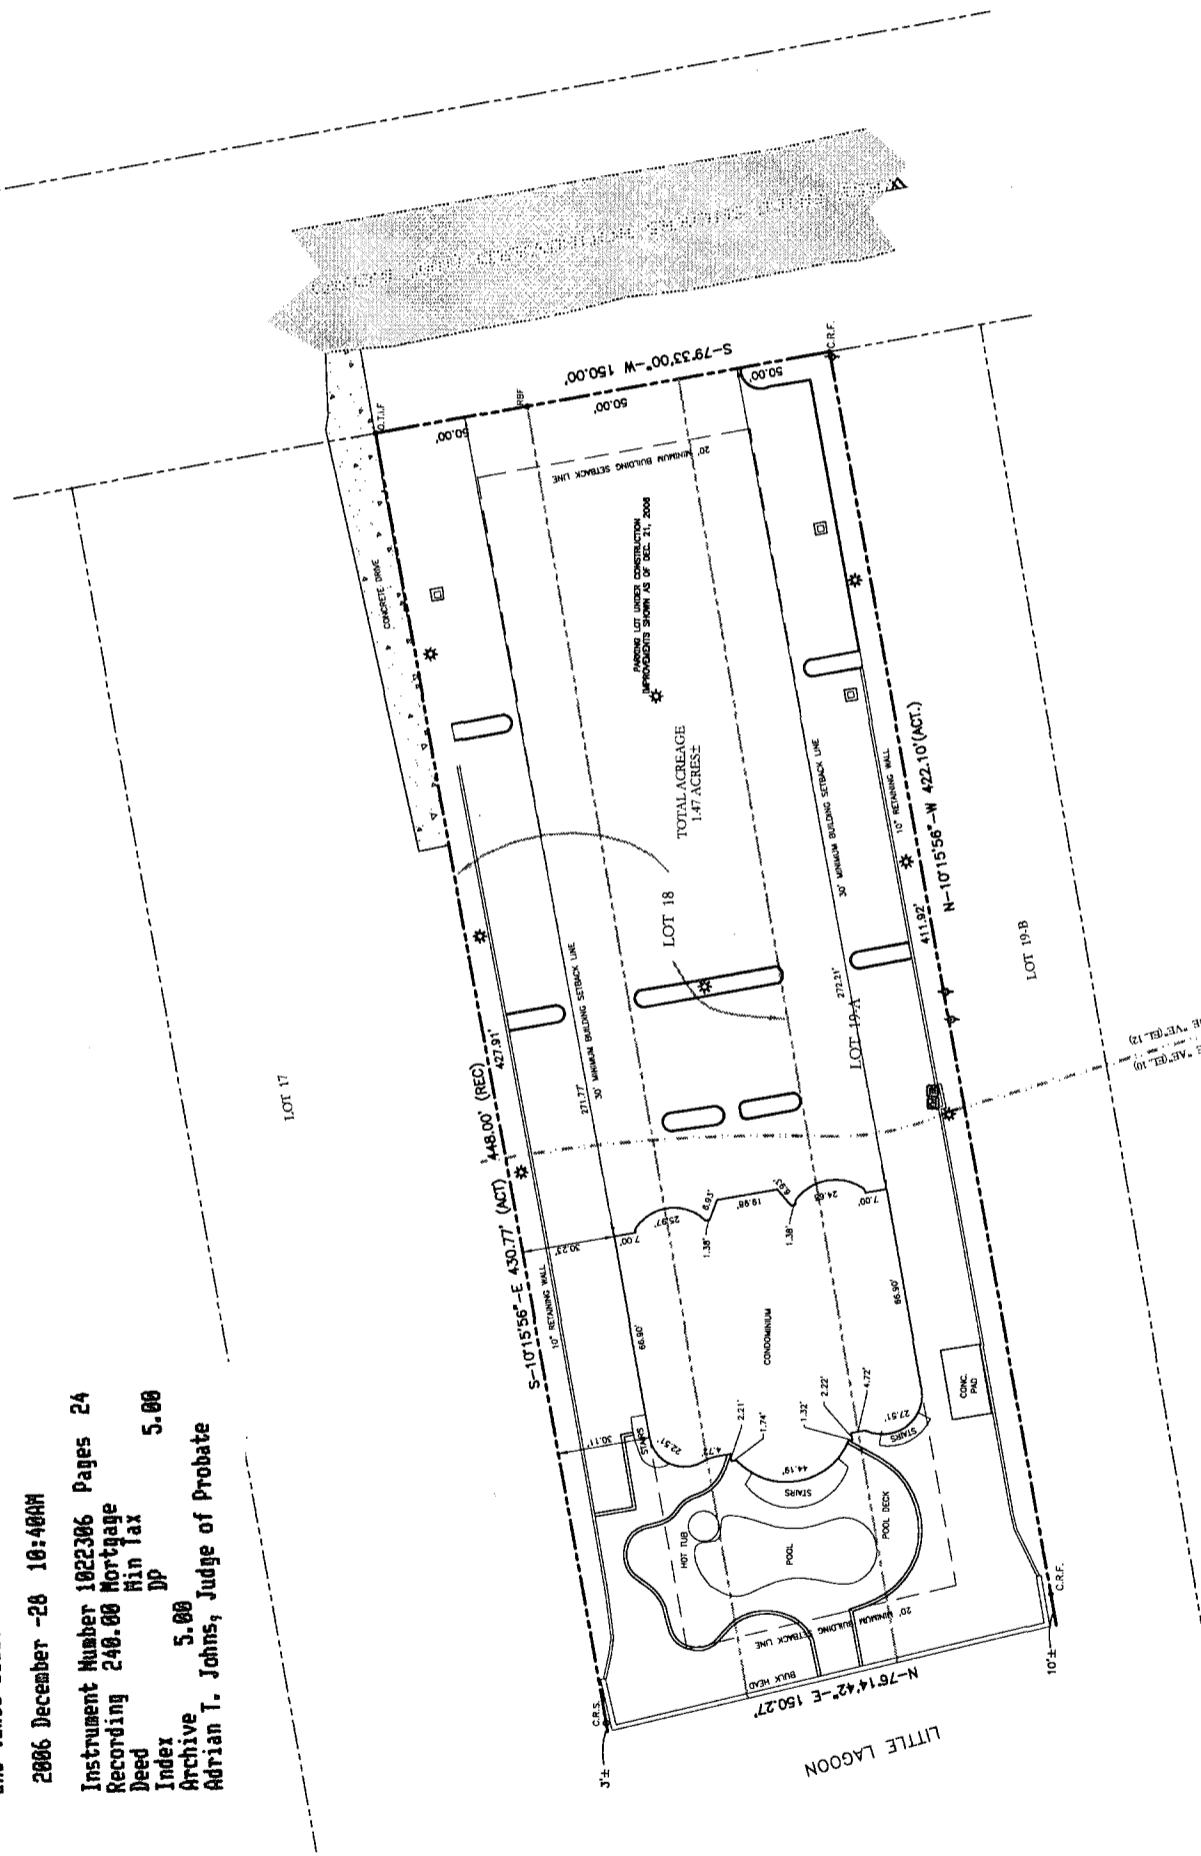

**ENGINEER'S CERTIFICATION**  
I, DOUGLAS A. BAILEY, A LICENSED PROFESSIONAL ENGINEER IN THE STATE OF ALABAMA (ALABAMA LICENSE NUMBER 21541), HEREBY CERTIFIES THAT THIS PLAT CONSISTING OF BOTH AN AS-BUILT SURVEY, PREPARED AND SIGNED BY ERIC L. GODWIN, A LICENSED PROFESSIONAL LAND SURVEYOR IN THE STATE OF ALABAMA (ALABAMA LICENSE NUMBER 26621), AND A SITE GRADING AND DRAINAGE PLAN, SIGNED AND DATED BY MYSELF AND UPON BOTH OF WHICH I HAVE RELIED FOR PURPOSES OF MAKING THIS CERTIFICATION, CONTAINS ALL INFORMATION REQUIRED BY § 35-8A-209 OF THE ALABAMA CODE (1975).

DOUGLAS A. BAILEY, P.E.  
ALABAMA LICENSE NUMBER 21541

12/27/06  
DATE

NOTE: THIS SURVEY IS NOT VALID WITHOUT THE SITE GRADING AND DRAINAGE PLAN ATTACHED HERETO.

**HUTCHINSON, MOORE & RAUCH, LLC**  
ENGINEERS & SURVEYORS  
LAND PLANNERS  
POST OFFICE BOX 1872  
FOLEY, ALABAMA 36536  
TEL (251) 970-2422  
FAX (251) 970-2425  
hmrfoley@hmrengineers.com

ALABAMA REGISTERED PROFESSIONAL ENGINEER  
NO. 21541  
DOUGLAS A. BAILEY

ALABAMA LICENSED PROFESSIONAL LAND SURVEYOR  
NO. 26621  
ERIC L. GODWIN

AS-BUILT SURVEY OF BEL SOLE, A CONDOMINIUM FOR THE ALABAMA UNIFORM CONDOMINIUM ACT  
SLACK-ALOST DEVELOPMENT

NO.	REVISION	DATE	ENGR.

SCALE 1"=30'  
DATE DECEMBER, 2006  
DRAWN BY KBH  
CHECKED BY  
SHEET 1 OF 2