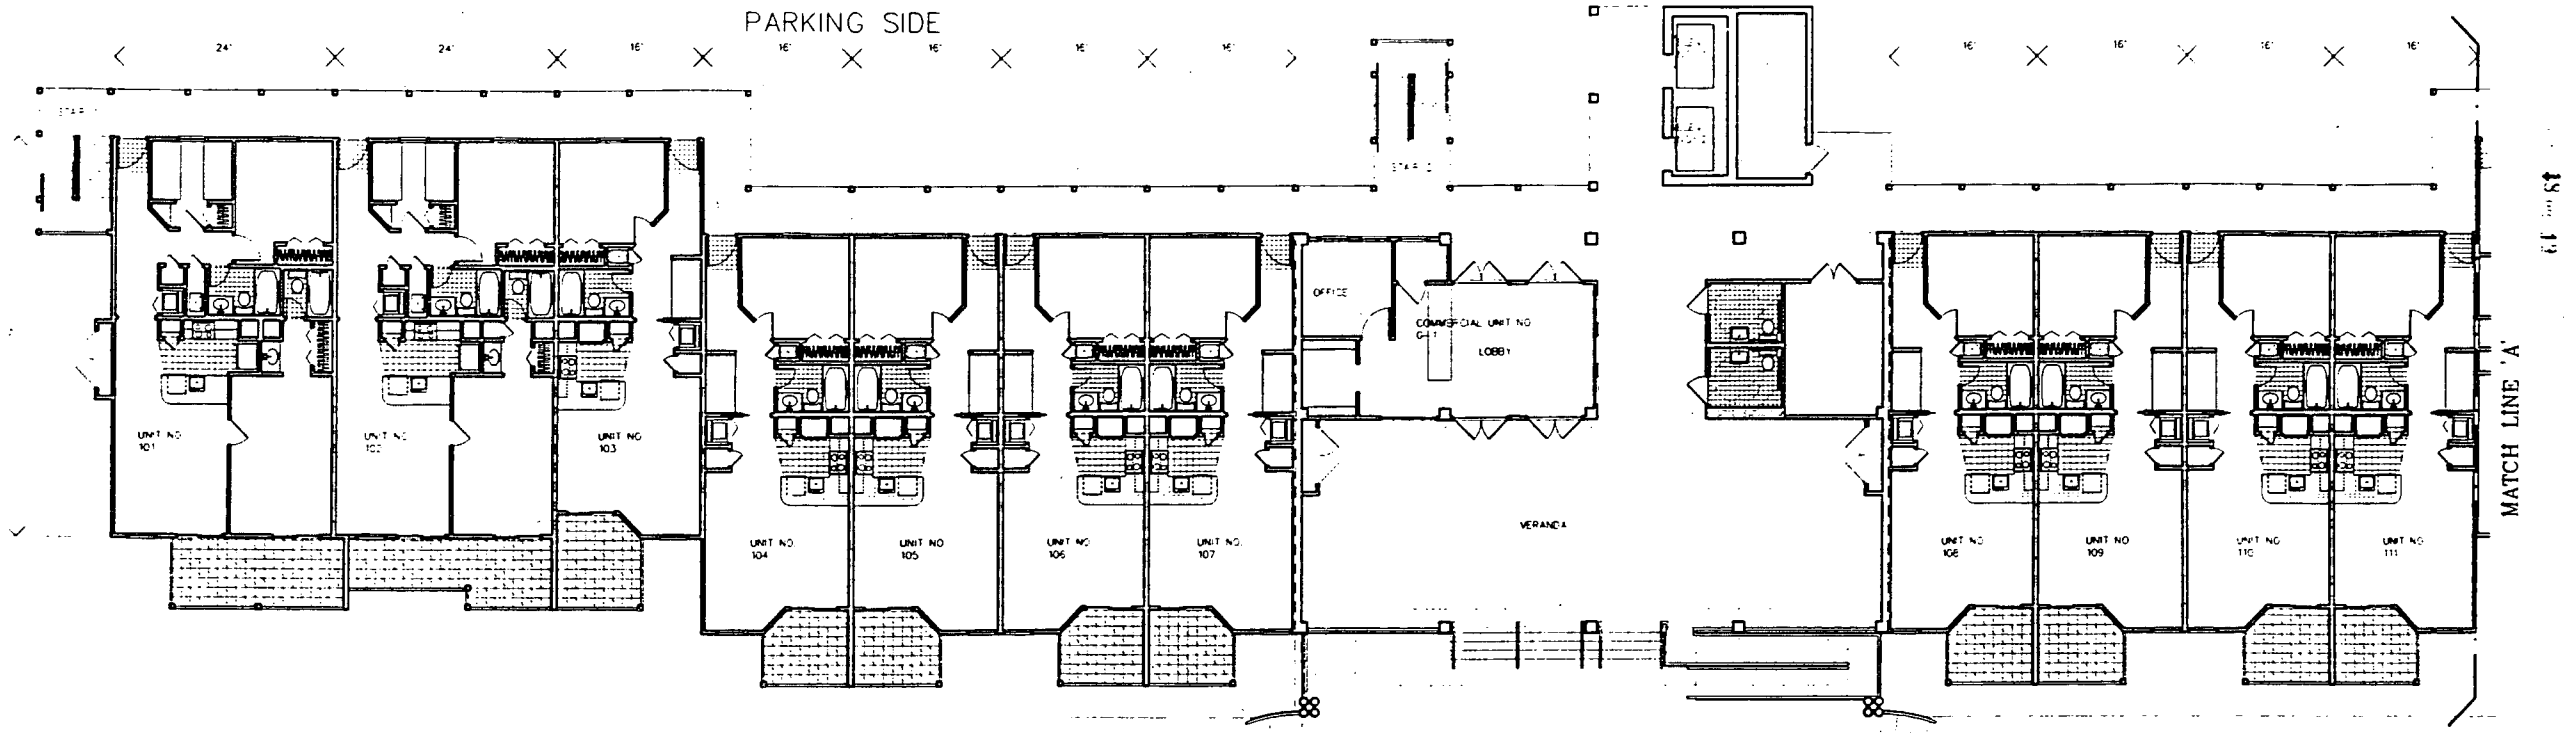

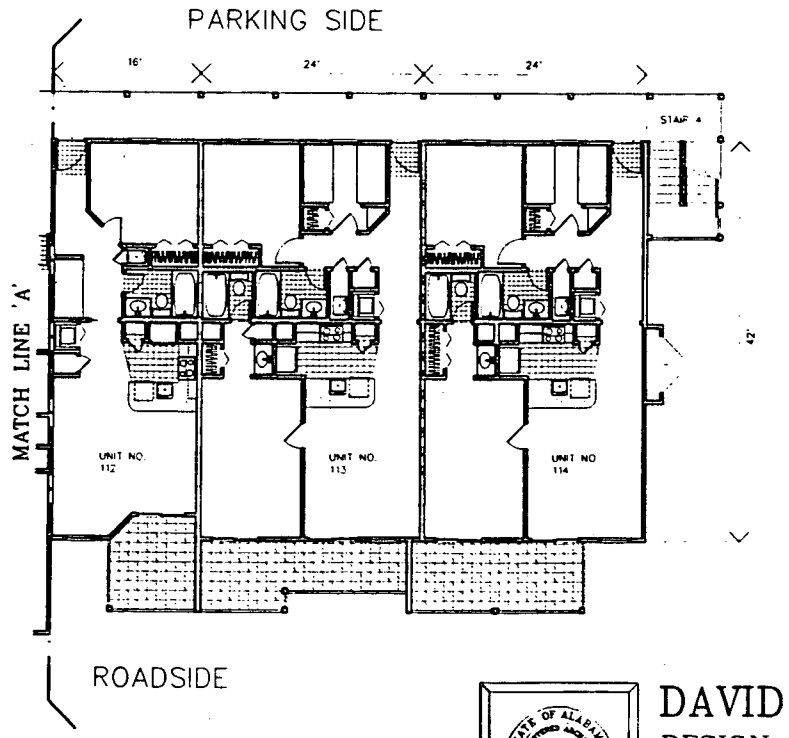

FIRST FLOOR PLAN

SCALE 1/8" = 1'-0"

CROSS HATCHED AREAS AND ALL WALLS REPRESENT COMMON ELEMENTS

REVERSED CROSS HATCHED AREAS REPRESENT LIMITED COMMON ELEMENTS (BALCONIES)

NON-CROSS HATCHED AREAS WITH THE EXCEPTION OF WALLS REPRESENT PRIVATE ELEMENTS

CERTIFICATION

THE UNDERSIGNED, DAVID W. LINDSEY, A REGISTERED ARCHITECT IN THE STATE OF ALABAMA, REGISTRATION NUMBER 2537, PURSUANT TO SECTION 35-8A-209, CODE OF ALABAMA, 1975, HEREBY CERTIFY THAT THE DRAWINGS CONSISTING OF PAGES 1 THROUGH 7 INCLUSIVE ATTACHED TO AND MADE A PART OF THE DECLARATION OF CONDOMINIUM OF THE GRAND BEACH RESORT, A CONDOMINIUM, CONTAINS ALL INFORMATION REQUIRED BY SAID SECTION, FULLY AND ACCURATELY DEPICT THE LAYOUT, LOCATIONS, UNIT NUMBERS AND DIMENSIONS IN SUFFICIENT DETAIL TO IDENTIFY THE COMMON ELEMENTS, LIMITED COMMON ELEMENTS AND PRIVATE ELEMENTS COMPRISING SUCH UNITS OF THE GRAND BEACH RESORT CONDOMINIUM, AS BUILT.

5 June 96

DAVID LINDSEY, ARCHITECT AL. REG. NO. 2537 DATE

STATE OF ALABAMA REGISTERED ARCHITECT SEAL DAVID LINDSEY

DAVID LINDSEY, ARCHITECT
DESIGN, PLANNING, INTERIORS
(334) 990-7447 FAX (334) 990-7443
111 N. SUMMIT STREET FAIRHOPE ALABAMA 36532

COMPOSITE FIRST FLOOR PLAN

DATED: 5 JUNE 1996

As-Built Drawings for
The
GRAND BEACH RESORT
Gulf Shores, Alabama

PROJ. 9606

SHEET NO. 2 OF

CUSHING RECORDS CORPORATION